





Wendy S. Fisher
Professional Engineer No. 47989
Date: October 24, 2013

I, Wendy S. Fisher, hereby certify that the information on shown herein is the result of an independent investigation and to the best of my knowledge and belief is true and correct.

LEGAL DESCRIPTION:
A parcel of land being a part of private subdivision 677, City of Taylor, County of Wayne, State of Michigan, being more particularly described as follows: Parcel 10, Meginnity Avenue (Old West Way), bounded and described as follows:
Beginning at a point which is located north 28 degrees 25 minutes 00 seconds west, 200.0 feet from the intersection of Center Street (shown north 81 degrees 10 minutes 00 seconds east) to the center line of Center Street, thence north 81 degrees 10 minutes 00 seconds east to a point on the center line of Center Street, thence along the center line of Center Street, north 28 degrees 25 minutes 00 seconds west, 527.00 feet, thence north 28 degrees 25 minutes 00 seconds east, 427.21 feet to the point of beginning.
Noting an easement over, under and upon the southerly 233.00 feet of the above described parcel for public utility purposes.
Reference is made to the plat of the same property as it is shown on the plat of the same property on N. Old Chalm Road recorded in Liber 27900, Page 216, Wayne County Records.
Should read Meginnity Avenue

GENERAL NOTES:
1) I warrant that the Commission of Standards & Practices Department of the State of Michigan has not been furnished the effect of amendments upon this parcel, other than indicated on this plan.

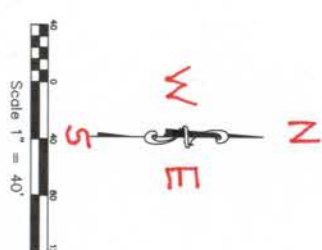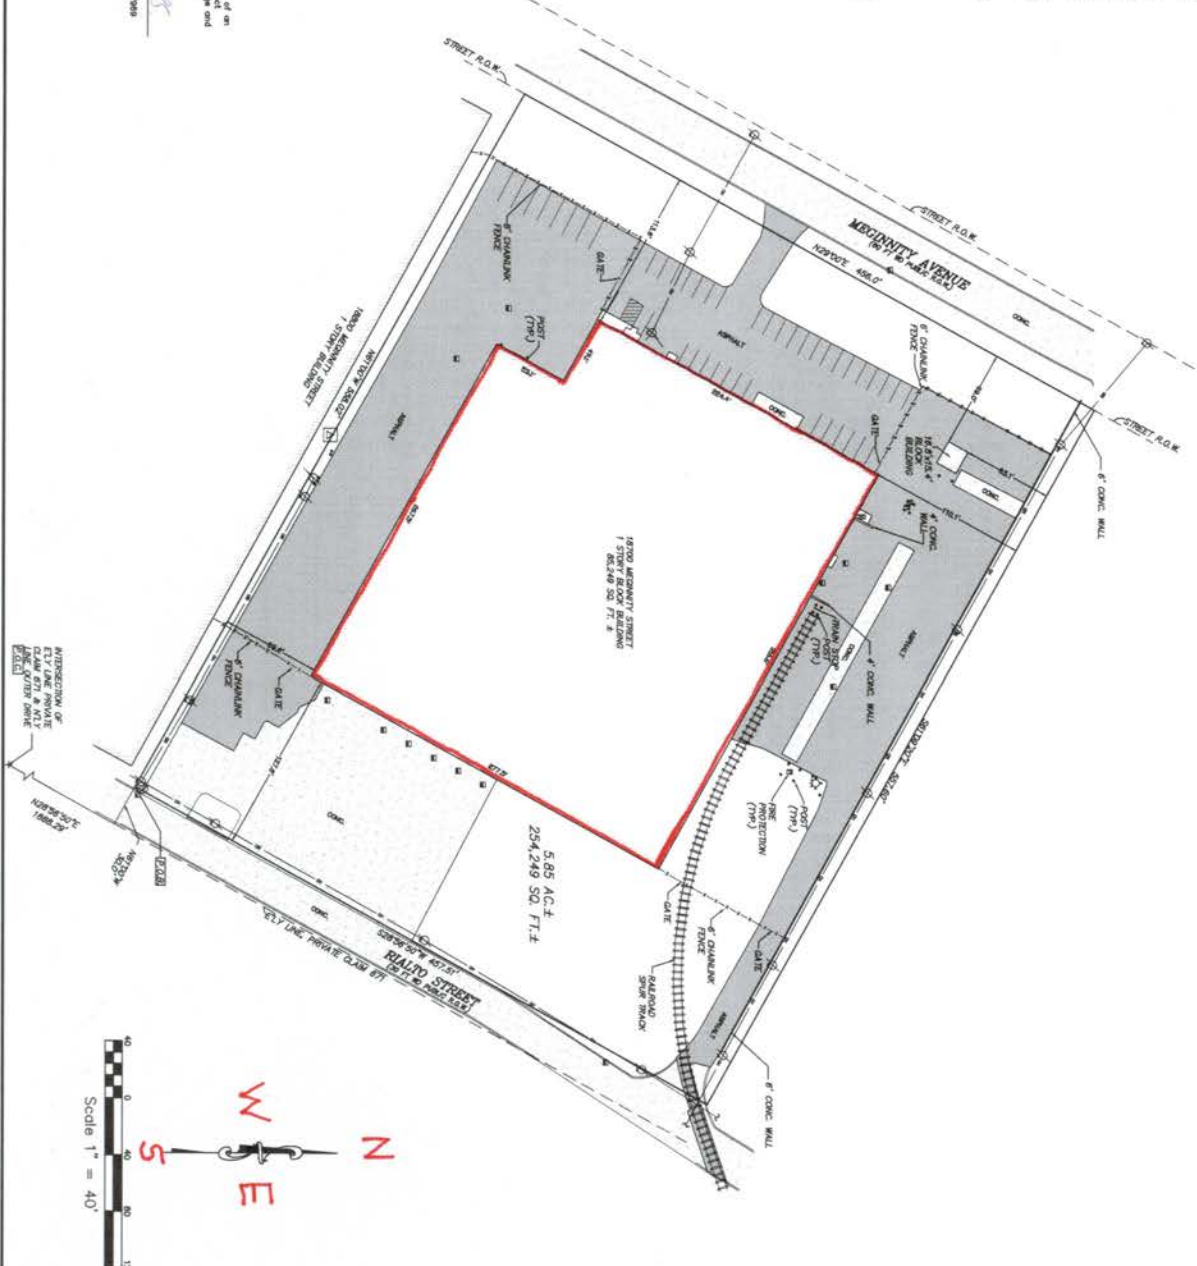

MISS DIG
3 BROWNS DIRT
RELOCATE TO 1437
1-800-482-7177
(TOLL FREE)

AS-BUILT SITE SURVEY
OF
18700 MEGINNITY AVENUE
MELINDALE, MI 48122

MACLEAN ENTERPRISES
PO BOX 69
TAYLOR, MI 48180

3125 PINE TREE ROAD
LANSING, MI 48211
TEL: (313) 383-5800
FAX: (313) 383-5800
WWW.MACLEAN-ENT.COM

ZSG
Engineers & Surveyors



LEGEND:

①	ADJACENT PROPERTY
②	ADJACENT ROAD
③	ADJACENT RAILROAD
④	ADJACENT WATERWAY
⑤	ADJACENT AIRWAY
⑥	ADJACENT POWER LINE
⑦	ADJACENT TELEPHONE LINE
⑧	ADJACENT GAS LINE
⑨	ADJACENT CABLE LINE
⑩	ADJACENT FENCE
⑪	ADJACENT GATE
⑫	ADJACENT DRIVE
⑬	ADJACENT SIDEWALK
⑭	ADJACENT CURB
⑮	ADJACENT DRIVEWAY
⑯	ADJACENT PORCH
⑰	ADJACENT PATIO
⑱	ADJACENT DECK
⑲	ADJACENT STAIRS
⑳	ADJACENT ELEVATOR
㉑	ADJACENT RAMP
㉒	ADJACENT WALKWAY
㉓	ADJACENT BIKEWAY
㉔	ADJACENT PLAYGROUND
㉕	ADJACENT SPORTS FIELD
㉖	ADJACENT TENNIS COURT
㉗	ADJACENT GOLF COURSE
㉘	ADJACENT PARK
㉙	ADJACENT GOLF GREEN
㉚	ADJACENT GOLF FAIRWAY
㉛	ADJACENT GOLF BUNKER
㉜	ADJACENT GOLF CART PATH
㉝	ADJACENT GOLF CLUBHOUSE
㉞	ADJACENT GOLF STORE
㉟	ADJACENT GOLF RESTAURANT
㊱	ADJACENT GOLF BAR
㊲	ADJACENT GOLF PRO SHOP
㊳	ADJACENT GOLF GOLFERS CLUB
㊴	ADJACENT GOLF GOLFERS ASSOCIATION
㊵	ADJACENT GOLF GOLFERS UNION
㊶	ADJACENT GOLF GOLFERS SOCIETY
㊷	ADJACENT GOLF GOLFERS CLUBHOUSE
㊸	ADJACENT GOLF GOLFERS STORE
㊹	ADJACENT GOLF GOLFERS RESTAURANT
㊺	ADJACENT GOLF GOLFERS BAR
㊻	ADJACENT GOLF GOLFERS PRO SHOP
㊼	ADJACENT GOLF GOLFERS CLUB
㊽	ADJACENT GOLF GOLFERS ASSOCIATION
㊾	ADJACENT GOLF GOLFERS UNION
㊿	ADJACENT GOLF GOLFERS SOCIETY

NO. 1437	DATE: 10/2/2013	PROJECT NO. 1437	SHEET NO. 1 OF 1
BY: W.S.F.	CHECKED BY: W.S.F.	DATE: 10/2/2013	
SCALE: 1" = 40'	PROJECT: N/A		