

# Attachment B- Redlined Site Plan


Redlined area indicates  
Electrolux's planned FTZ  
Acreage = 19.4  
Square footage = 846,803

**BUILDING INFORMATION**

Site Area	52.44 Acres
Total Building Area	965,183 sf
F.A.R.	0.42

**TENANT DATA:**


Tenant Floor Area:	365,303 SF
Office:	1,843 SF
Remote Shipping	310 SF
Warehouse	362,889 SF
Building Common (Pro-rata):	261 SF
Car Parking Spaces	50
Dock Doors w/ Levelers:	<del>26</del> 30
Trailer Spaces:	122
(between docks):	48
(across from docks):	74

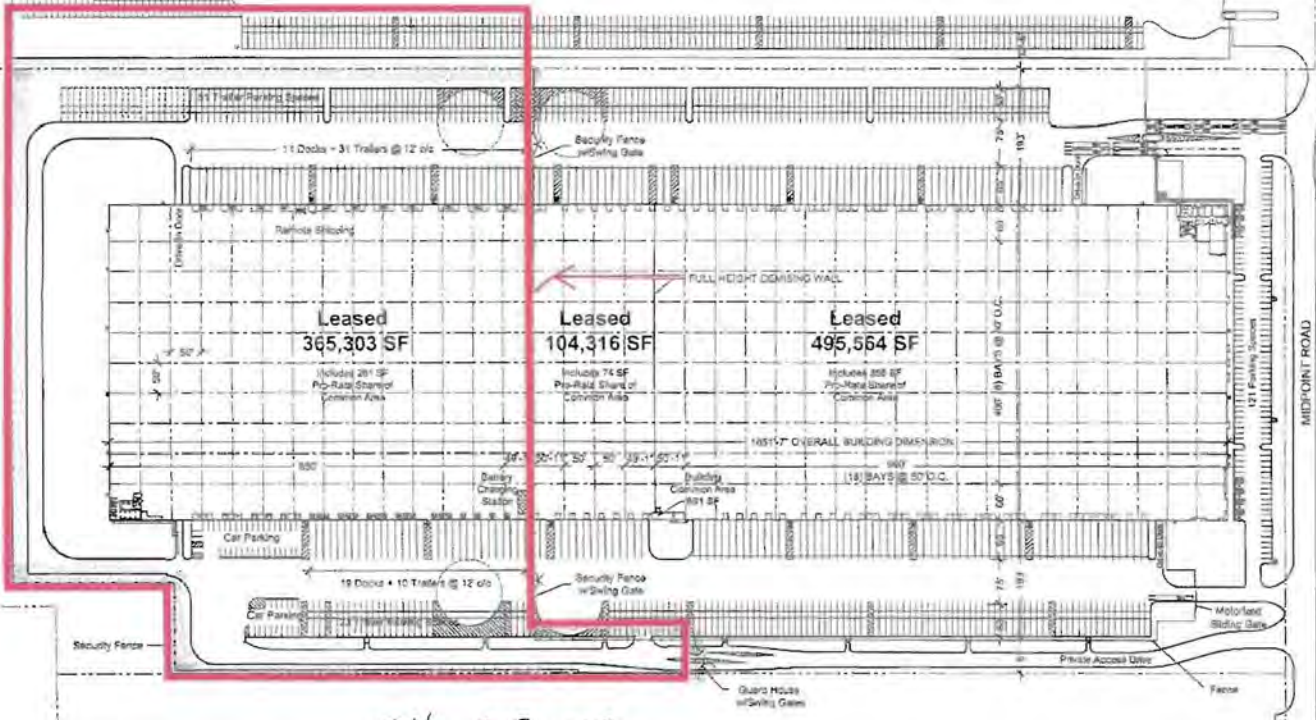

846,803 SF  
or 19.4 Acres Inside Fence / Demising wall

**Dock Symbol Legend**

	Full Service Dock
	Door, PL, and Leveler Only
	Door Only

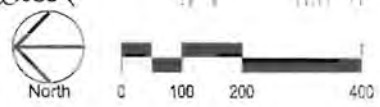

Location Map



Redlined area indicates  
Electrolux's FTZ  
Acreage = 19.4  
Square footage = 846,803  
Address:  
803 Midpoint Road  
Minooka, IL 60447

To see all the details that are visible on the screen, use the "Print" link next to the map