

EL PASO/WESTPORT FOREIGN TRADE ZONE
CITY OF EL PASO, EL PASO COUNTY, TEXAS


EXHIBIT

Cutts Land Surveying, Inc.

Professional Land Surveyors
1100 Montana Avenue, Suite 206
El Paso, Texas 79902
Ph. (915) 534-9391
Fx. (915) 534-9394

Date: 01-21-99
Job No.: 990114

Red = Requested Boundaries

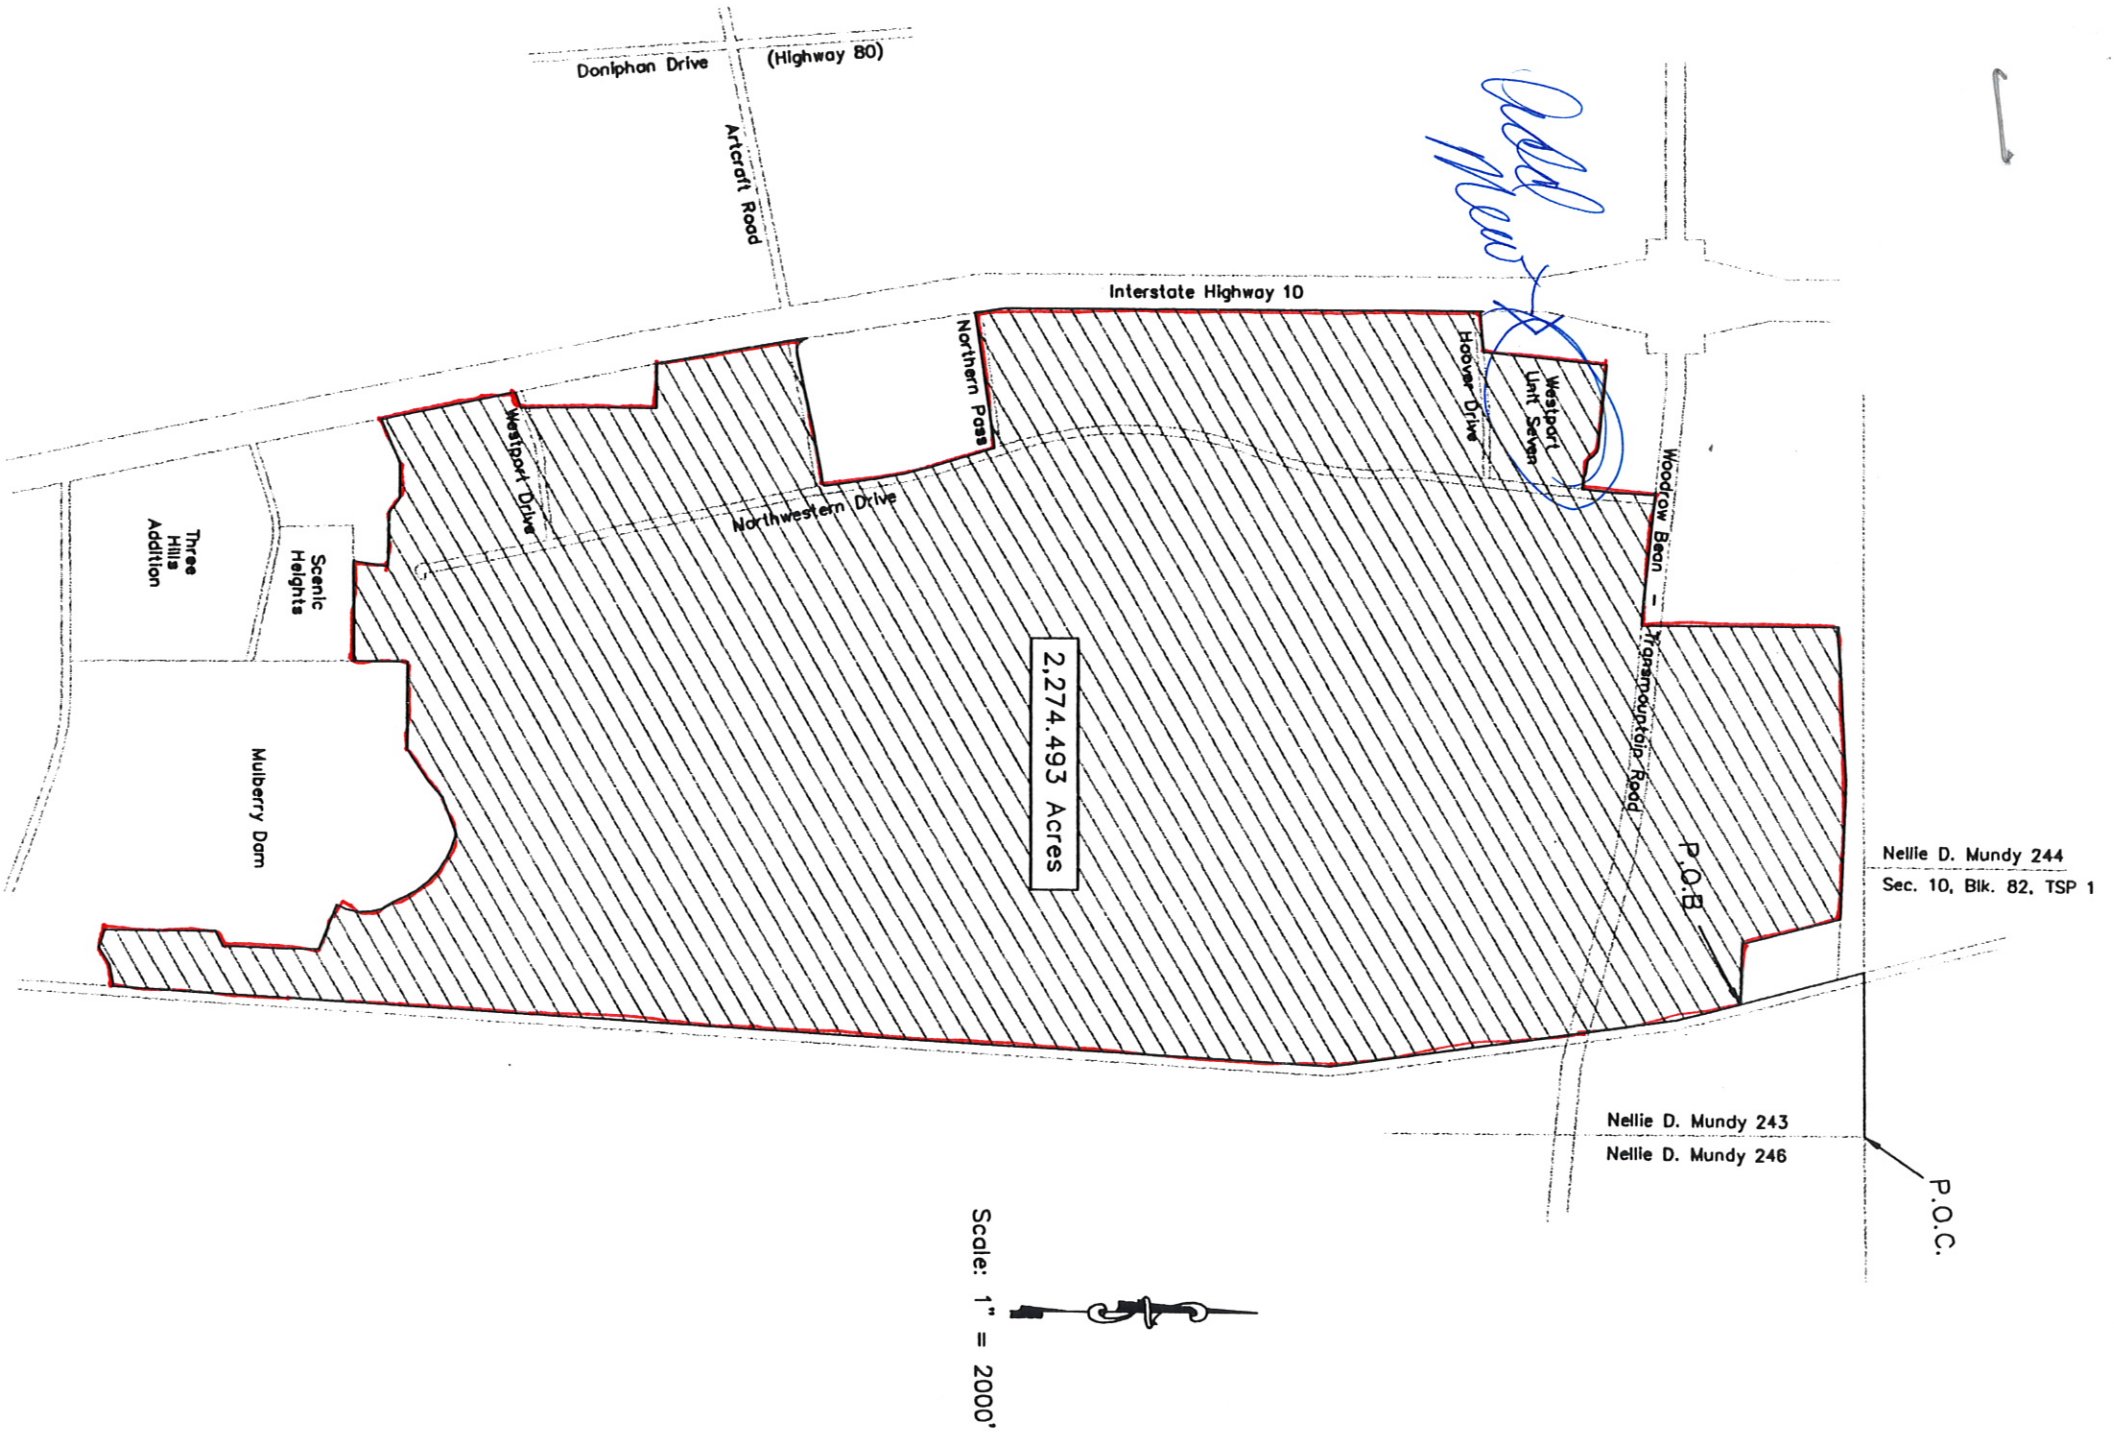

Red lines