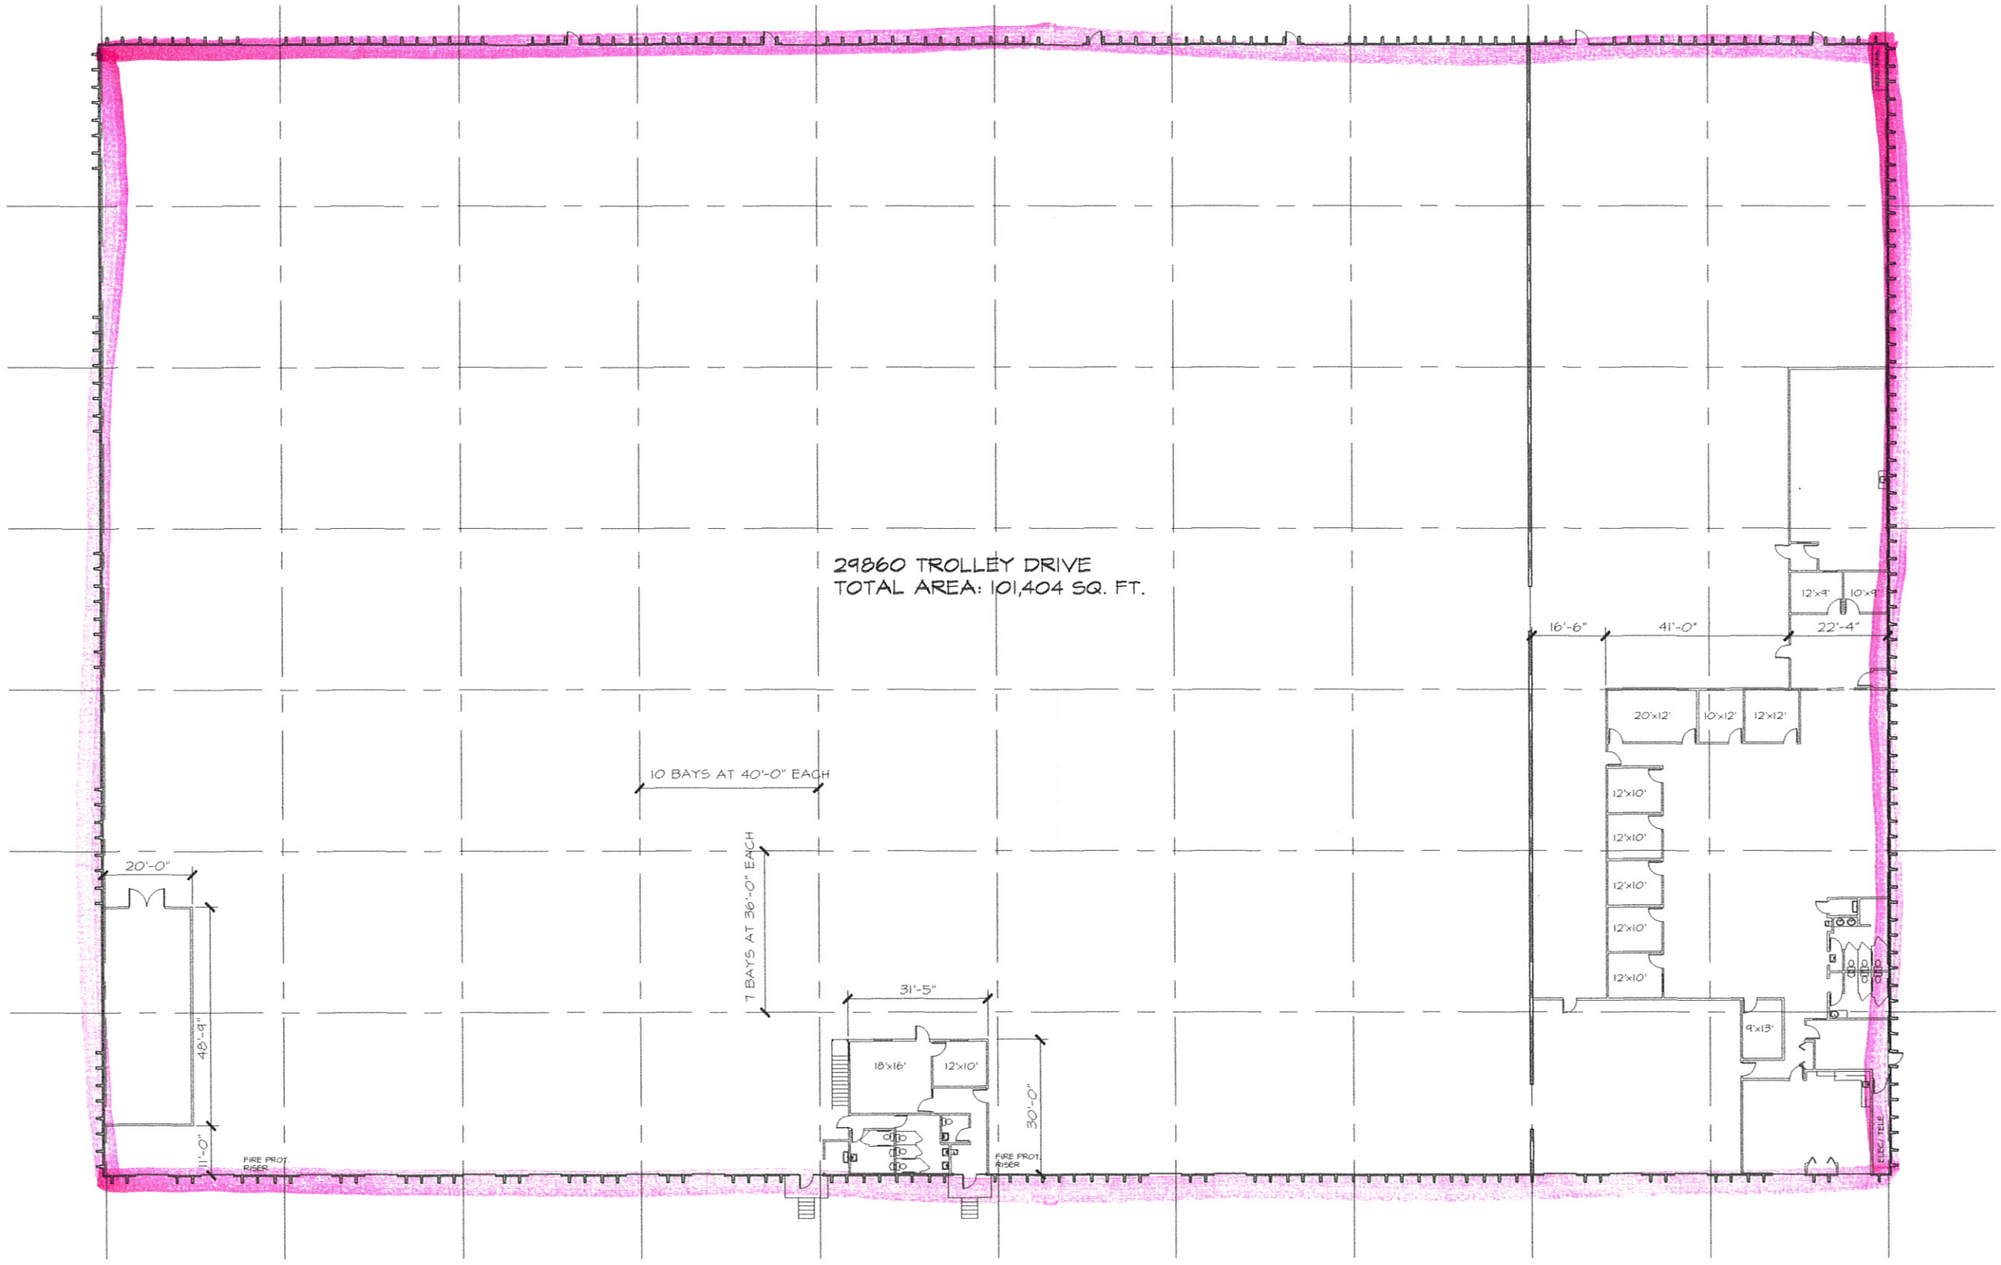

FT 2 BOUNDARY

FLOOR PLAN

SCALE: 1/16" = 1'-0"

AS-BUILT FLOOR PLAN

smith+schurman associates, inc.
architects ☐ planners ☐ interior designers
2550 telegraph road, suite 108, bloomfield hills, mi 48302
phone: (248) 332-3140 facsimile: (248) 332-3277

FIRST INDUSTRIAL REALTY TRUST, INC.
AS-BUILT
29860 TROLLEY INDUSTRIAL
TAYLOR, MICHIGAN

FIRST INDUSTRIAL

ISSUE	DATE
AS-BUILT	7/11/10
PLOT SCALE	1:1

DRAWN BY:	JN
CHECKED BY:	
JOB NO:	01-6494
FILENAME: 6494A100.DWG	
SHEET NUMBER:	A-201