Attachment 5
Redlines Proposed Site Map

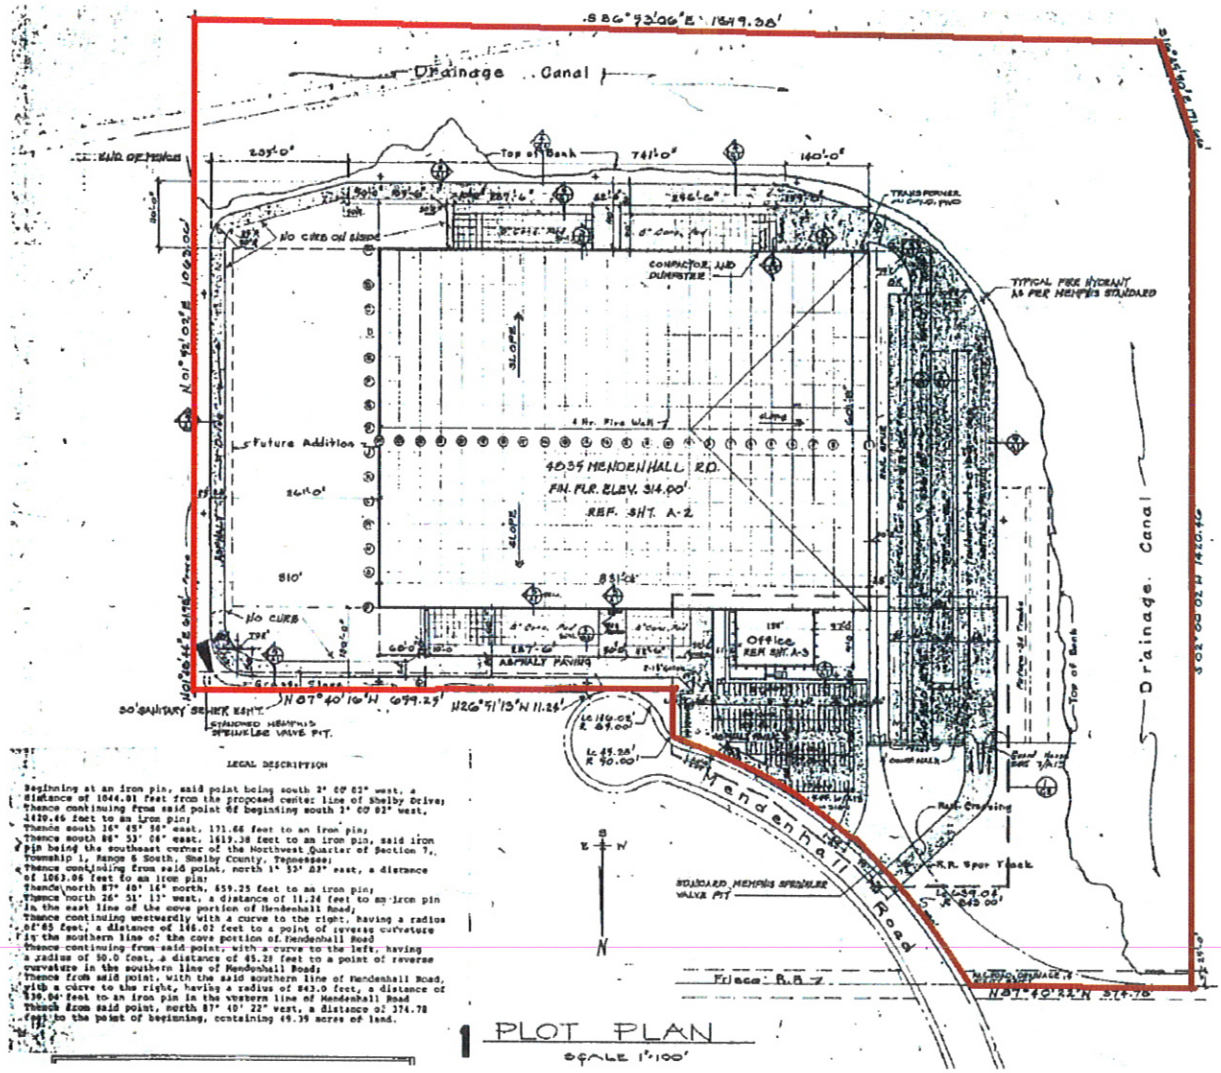

LEGAL DESCRIPTION

Beginning at an iron pin, said point being south 3° 00' 02" west, a distance of 1044.01 feet from the proposed center line of Shelby Drive; Thence continuing from said point of beginning south 3° 00' 02" west, 1420.46 feet to an iron pin;
Thence south 16° 45' 56" east, 171.66 feet to an iron pin;
Thence south 86° 53' 04" east, 1619.38 feet to an iron pin, said iron pin being the southeast corner of the Northwest Quarter of Section 7, Township 1, Range 6 South, Shelby County, Tennessee;
Thence continuing from said point, north 1° 53' 03" east, a distance of 1063.06 feet to an iron pin;
Thence north 87° 40' 16" north, 659.25 feet to an iron pin;
Thence north 26° 51' 13" west, a distance of 11.24 feet to an iron pin in the east line of the cove portion of Mendenhall Road;
Thence continuing westwardly with a curve to the right, having a radius of 87.65 feet, a distance of 146.02 feet to a point of reverse curvature in the southern line of the cove portion of Mendenhall Road
Thence continuing from said point, with a curve to the left, having a radius of 90.0 feet, a distance of 45.28 feet to a point of reverse curvature in the southern line of Mendenhall Road;
Thence from said point, with the said southern line of Mendenhall Road, with a curve to the right, having a radius of 843.0 feet, a distance of 539.04 feet to an iron pin in the western line of Mendenhall Road
Thence from said point, north 87° 40' 22" west, a distance of 374.78 feet to the point of beginning, containing 49.39 acres of land.