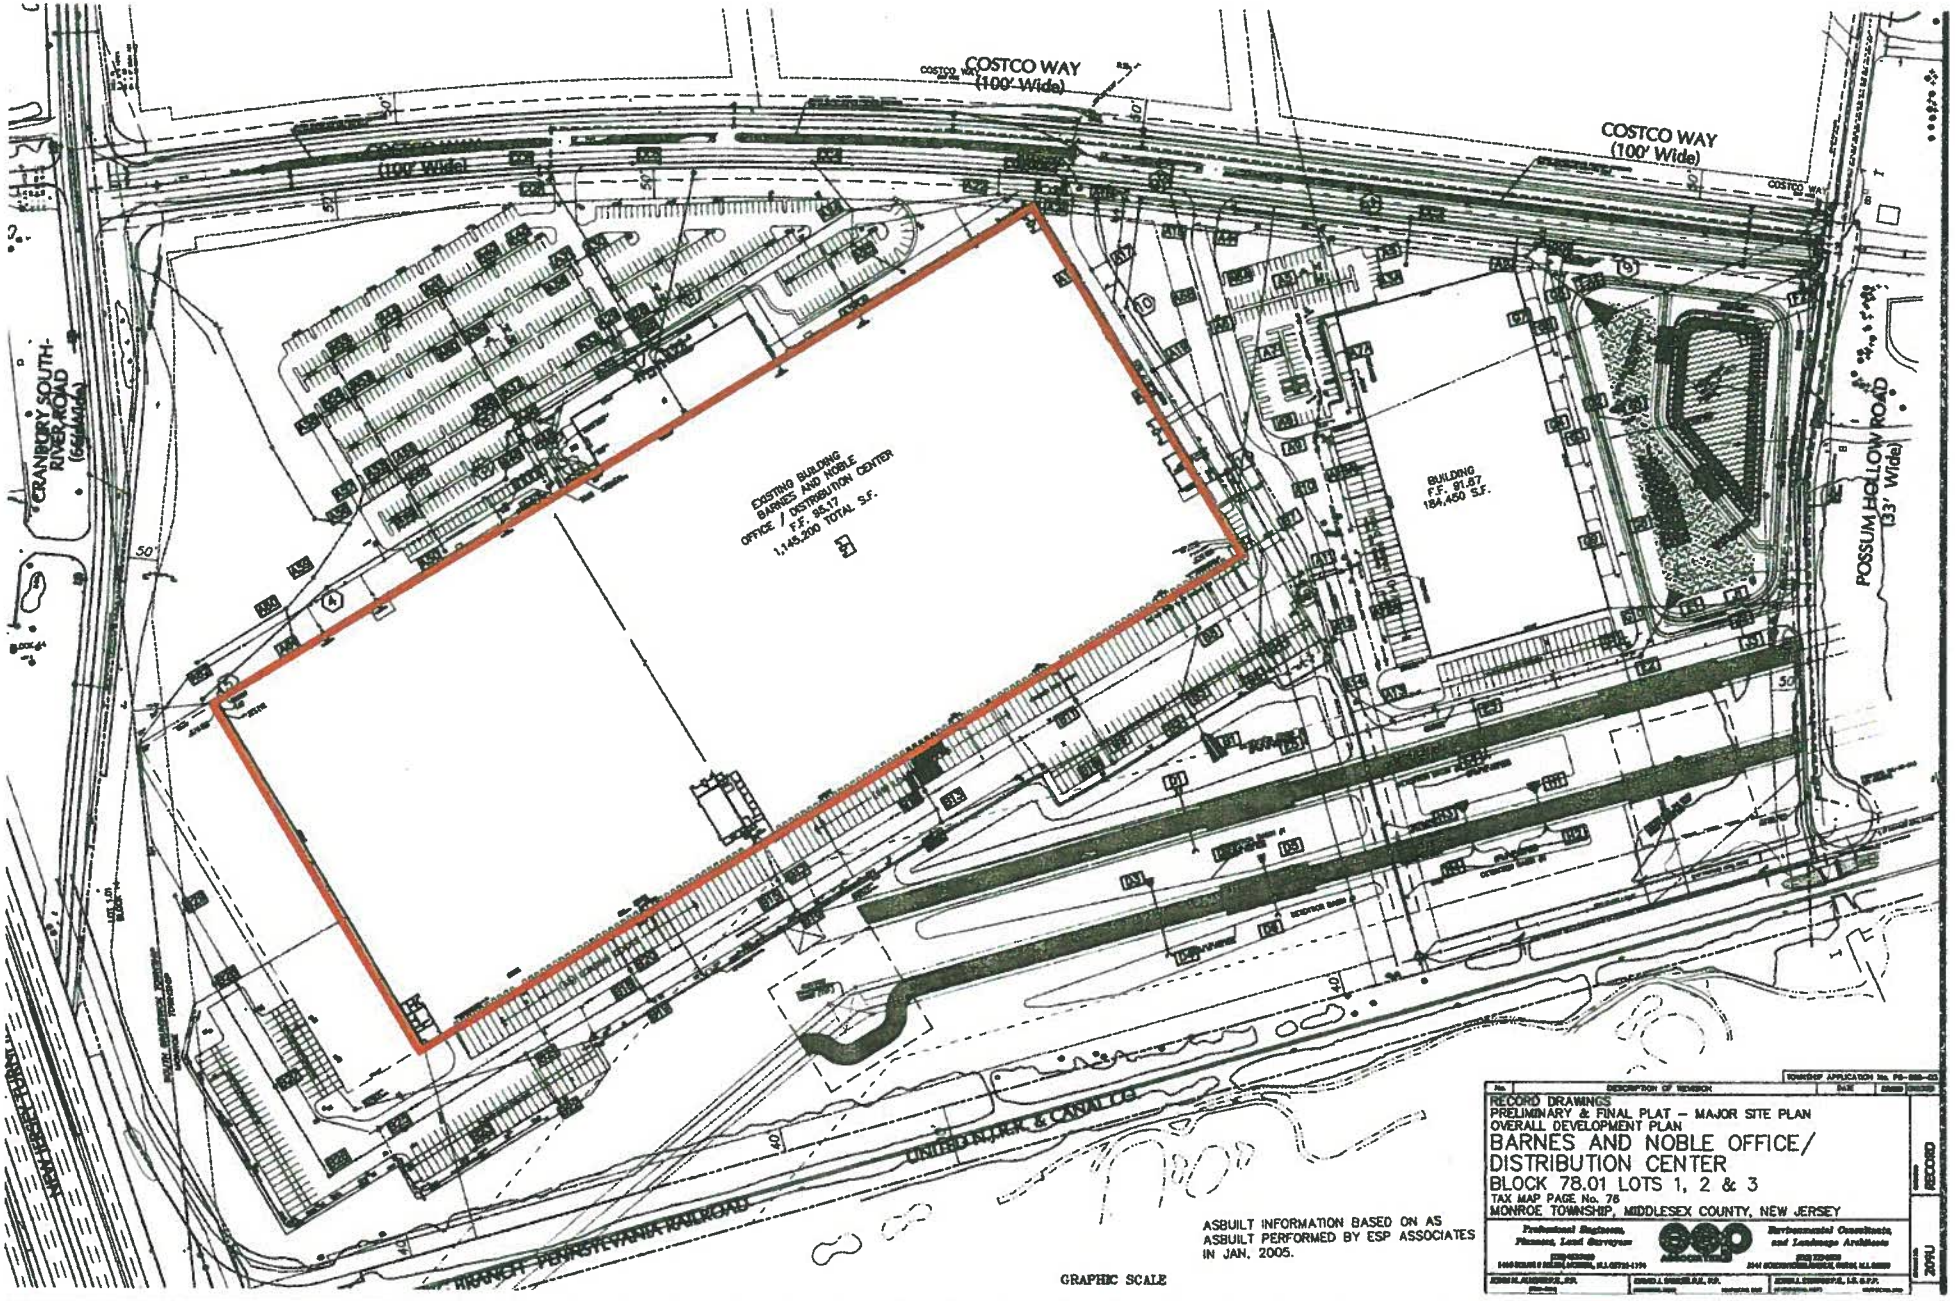

ASBUILT INFORMATION BASED ON AS ASBUILT PERFORMED BY ESP ASSOCIATES IN JAN. 2005.

No.	DESCRIPTION OF REVISION	DATE	DRAWN	CHECKED

TOWNSHIP APPLICATION No. PB-[illegible]-03

RECORD DRAWINGS
PRELIMINARY & FINAL PLAT – MAJOR SITE PLAN
OVERALL DEVELOPMENT PLAN

BARNES AND NOBLE OFFICE/ DISTRIBUTION CENTER

BLOCK 78.01 LOTS 1, 2 & 3
TAX MAP PAGE No. 78
MONROE TOWNSHIP, MIDDLESEX COUNTY, NEW JERSEY

Professional Engineers, Planners, Land Surveyors
ESP ASSOCIATES
Environmental Consultants and Landscape Architects

RECORD

PLANE

N
Freehold
Old Bridge
East Brunswick
Middlesex
Monroe Township
Princeton Meadows
Current Site 4
Proposed Space
Current Site 5
Current Site 6
Current Site 3